

Monday, 9/10/2007 1:31:37 PM  
Kim Johnston

## Process Sheet

Customer	: CU-DAR001 Dart Helicopters Services	Drawing Name	: BRACKET ASSEMBLY
Job Number	: 34514		
Estimate Number	: 10291	Part Number	: D3183044
P.O. Number	: <i>N/A</i>	Drawing Number	: D3183 REV C1
This Issue	: 09/10/2007 S.O. No. : <i>MA</i>	Project Number	: N/A
Prsht Rev.	: NC	Drawing Revision	: C1
First Issue	: <i>N/A</i> Type : MACHINED PARTS	Material	: <i>N/A</i>
Previous Run	: 31732	Due Date	: 9/30/2007
Written By	: <i>[Signature]</i>	Qty:	8 Um: Each
Checked & Approved By	: <i>[Signature]</i>		
Comment	: Est Rev. Pick: A 04.02.18 New issue KJ/DS		

Additional Product

Job Number:



Seq. #:	Machine Or Operation:	Description :
---------	-----------------------	---------------

1.0	M174B2000X01500	17-4 SS Bar
-----	-----------------	-------------



Comment: Qty.: 0.4812 f(s)/Unit Total: 3.8497 f(s)  
Material: 17-4 SS Bar per AMS 5604/5643  
(M17-4-B1.500x02.000)  
Identify for D3183-4  
Batch: *M103089*

*→ 2 blanks*  
*\*M14773\**

*HA 07/11/12*

2.0	BAND SAW	BAND SAW
-----	----------	----------



Comment: BAND SAW  
Cut blanks: (1.500" x 2.000") 5.500" long

*HA 07/11/12*

3.0	HAAS1	HAAS CNC VERTICAL MACHINING #1
-----	-------	--------------------------------



Comment: HAAS CNC VERTICAL MACHINING #1

1-Machine D3183-4 as per Folio FA322 and Dwg D3183  
Identify as D3183-4

2-Deburr

3-Scribe batch number

*SA/HA 07/11/12*

4.0	QC2	INSPECT PARTS AS THEY COME OFF MACHINE
-----	-----	--



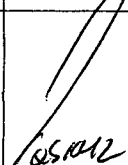

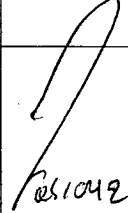
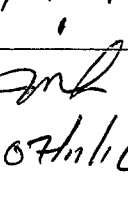
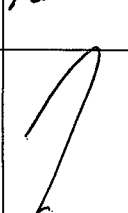



Comment: INSPECT PARTS AS THEY COME OFF MACHINE

*SA/HA 07/11/12*

W/O:		WORK ORDER CHANGES					
DATE	STEP	PROCEDURE CHANGE	By	Date	Qty	Approval Chief Eng / Prod Mgr	Approval QC Inspector

Part No: \_\_\_\_\_ PAR #: \_\_\_\_\_ Fault Category: \_\_\_\_\_ NCR: Yes ☒ No ☐ DQA: D Date: 07/10/20  
 QA: N/C Closed: \_\_\_\_\_ Date: \_\_\_\_\_

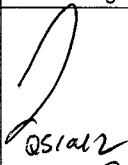NCR:		WORK ORDER NON-CONFORMANCE (NCR)						
DATE	STEP	Description of NC Section A	Corrective Action Section B			Verification Section C	Approval Chief Eng	Approval QC Inspector
			Initial Chief Eng	Action Description Chief Eng	Sign & Date			
07.11.13	3.0	- 1 part - 'Y' origin not taken properly. (New machinist)	 05/10/12	Scrap & replace	SA 07.11.13	 07.11.14	 05/10/12	 07.11.14
07/11/15	3.0	1 part scrap drill bit broke inside the of the part	 05/10/12	Scrap → destroy & replace	BA 07/11/16	 07/11/16	 05/10/12	 07.11.16

NOTE: Date & initial all entries

Date: Monday, 9/10/2007 1:31:37 PM  
User: Kim Johnston

## Process Sheet

Customer: CU-DAR001 Dart Helicopters Services

Drawing Name: BRACKET ASSEMBLY

Job Number: 34514

Part Number: D3183044

Job Number:



Seq. #:

Machine Or Operation:

Description :

5.0

QC8

SECOND CHECK



Comment: SECOND CHECK

*mk 07/11/16*

*(8)*

6.0

D312121

Bolt



Comment: Qty.: 2.0000 Each(s)/Unit Total : 16.0000 Each(s)

Pick:

Qty Part Number

Description Batch

2 D3121-21

Bolt

*B 33503 X 12mm*

*B 34522 X 4mm*

*8.8 07/11/20*

7.0

D3183045

Bearing Assembly



Comment: Qty.: 2.0000 Each(s)/Unit Total : 16.0000 Each(s)

Pick:

Qty Part Number

Description Batch

2 D3183-045 Bearing Ass

*B 36369*

*mf 07-12-20*

8.0

SMALL FAB 1

SMALL & MEDIUM FAB RESOURCE 1



Comment: SMALL & MEDIUM FAB RESOURCE 1

Assemble D3183-043 as per Dwg D3183.

*mf 07-12-20*

9.0

QC5

INSPECT WORK TO CURRENT STEP



Comment: INSPECT WORK TO CURRENT STEP

*8.8 07/12/20 (8)*

10.0

PACKAGING 1

PACKAGING RESOURCE #1



Comment: PACKAGING RESOURCE #1

Identify and Stock

Location: \_\_\_\_\_

*7/12/20*

*SP*

*(8x)*

11.0

QC21

FINAL INSPECTION/W/O RELEASE



Comment: FINAL INSPECTION/W/O RELEASE

*07/12/20*

Job Completion



*U 07/12/20*

W/O:		WORK ORDER CHANGES					
DATE	STEP	PROCEDURE CHANGE	By	Date	Qty	Approval Chief Eng / Prod Mgr	Approval QC Inspector

Part No: \_\_\_\_\_ PAR #: \_\_\_\_\_ Fault Category: \_\_\_\_\_ NCR: Yes No DQA: \_\_\_\_\_ Date: \_\_\_\_\_

QA: N/C Closed: \_\_\_\_\_ Date: \_\_\_\_\_

NCR:		WORK ORDER NON-CONFORMANCE (NCR)						
DATE	STEP	Description of NC Section A	Corrective Action Section B			Verification Section C	Approval Chief Eng	Approval QC Inspector
			Initial Chief Eng	Action Description Chief Eng	Sign & Date			

NOTE: Date & initial all entries

<b>DART AEROSPACE LTD</b>		<b>Work Order:</b>	34514
<b>Description:</b> Bracket		<b>Part Number:</b>	D3183-4
<b>Inspection Dwg:</b> D3183	<b>Rev:</b> C1	<b>Page 1 of 1</b>	

### FIRST ARTICLE INSPECTION CHECKLIST

☒ First Article ☐ Prototype

Drawing Dimension	Tolerance	Actual Dimension	Accept	Reject	Method of Inspection	Comments
R0.190	+/-0.030	R.190	/			
R0.063	+/-0.010	R.063	/			
0.182	+/-0.010	.182	/			
0.070	+/-0.010	.073	/			
0.100	+/-0.010	.100	/			
Ø0.201 x 0.100	+/-0.010	.197x.102	/			
0.182	+/-0.010	.184	/			
5.32	+/-0.030	5.323	/			
5.036	+/-0.010	5.036	/			
2.120	+/-0.010	2.120	/			
1.290	+/-0.010	1.250	/			
0.365	+/-0.010	.365	/			
0.218	+/-0.010	.216	/			
1.030	+/-0.010	1.030	/			
1.90	+/-0.030	1.890	/			
1.012	+/-0.010	1.012	/			
Ø0.201 x 0.100	+/-0.010	Ø.197x.100	/			
0.182	+/-0.010					Not on drawing
0.786	+/-0.010	.785	/			
Ø0.392	+0.002/-0.000	Ø.392	/			
R0.19	+/-0.030	R.190	/			
3.954	+/-0.010	3.954	/			
0.162	+/-0.010	.162	/			
R0.19	+/-0.030	R.190	/			
R0.25	+/-0.030	R.250	/			
4.26	+/-0.030	4.263	/			
2.800	+/-0.030	2.800	/			
Calculated dimension						
0.162	+/-0.010	.159	/			
0.615	+/-0.010	.615	/			
0.435	+/-0.010	.432	/			
0.200	+/-0.010	.201	/			
0.381	+/-0.010	.380	/			
0.032	+/-0.010	.032	/			


<b>Measured by:</b> SA	<b>Audited by:</b> J.L	<b>Prototype Approval:</b>	N/A
<b>Date:</b> 03.11.13	<b>Date:</b> 07/11/14	<b>Date:</b>	N/A

Rev	Date	Change	Revised by	Approved
A	03.11.12	New Issue P/O D3183-044	KJ/RF	
B	04.03.15	Changes as per revision C	KJ/JLM/RF	
C	04.06.15	Dimension 2.800 was 2.080; removed 1.155, 0.36 dimensions	KJ/JLM	
D	06.03.09	Dwg Rev update	KJ/JLM	




DESIGN #	DRAWN BY CP	<b>DART AEROSPACE LTD</b> HAWKESBURY, ONTARIO, CANADA	
CHECKED #	APPROVED #	DRAWING NO. <b>D3183</b>	REV. C SHEET 1 OF 4
DATE <b>04.02.17</b>		TITLE <b>BRACKET ASSEMBLY</b>	SCALE 1:1
A.	03.01.24	NEW ISSUE	
B.	03.06.17	REMOVE BEARING; 1.012 WS 0.882	
C.	04.02.17	ADD -045/-9; 0.182 WAS 0.431	
CI	<del>04.11.09</del>	<del>0.830 WAS 0.850</del>	

RELEASED  
04.03.01

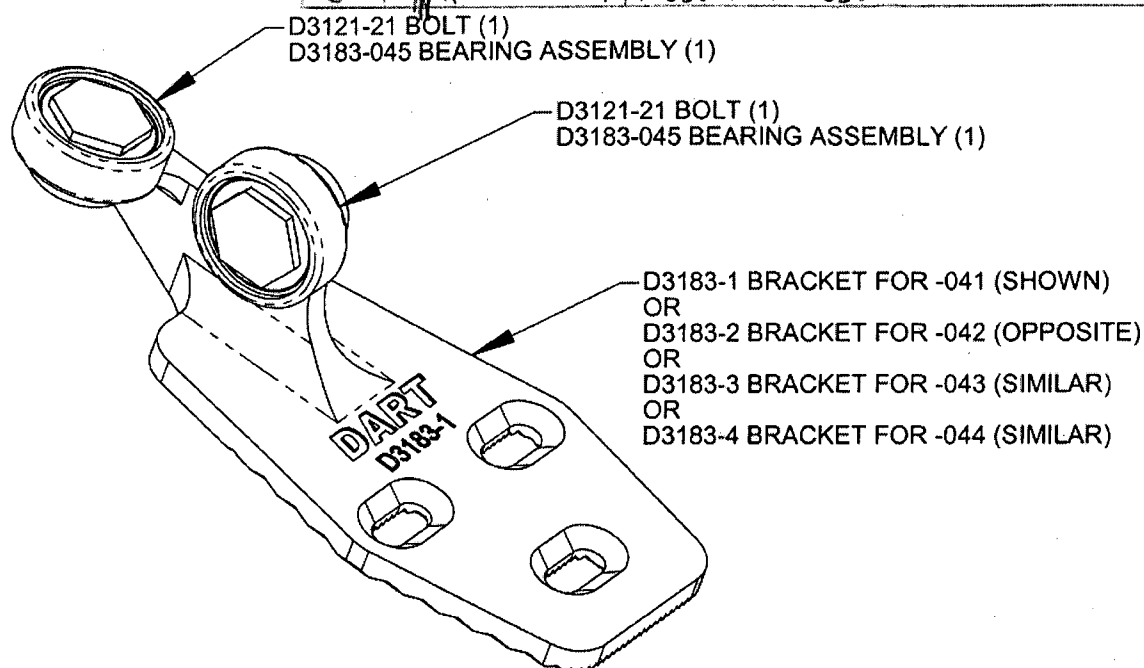

**D3183-041 BRACKET ASSEMBLY (SHOWN)**  
**D3183-042 BRACKET ASSEMBLY (OPPOSITE)**  
**D3183-043 BRACKET ASSEMBLY (SIMILAR)**  
**D3183-044 BRACKET ASSEMBLY (SIMILAR)**

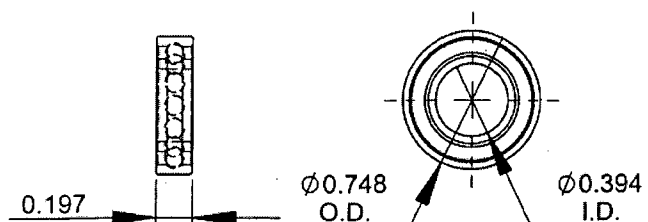


**D3183-5 BEARING:**  
**SPECIFICATION CONTROL DRAWING**

- 1) SINGLE ROW, DEEP GROOVE, SHOP COPY CONRAD TYPE, SHIELDED
  - 2) POSSIBLE SUPPLIER: NSK P/N 6800ZZ
  - 3) ALL DIMENSIONS ARE IN INCHES
- RETURN TO  
ENGINEERING  
UNCONTROLLED COPY  
SUBJECT TO AMENDMENT  
WITHOUT NOTICE

**D3183-7 WASHER**

- 1) MATERIAL: AISI 303 ROUND BAR (M303R) ANNEALED
- 2) BREAK ALL SHARP EDGES 0.005 TO 0.010
- 3) TOLERANCES ARE PER DART QSI 018 UNLESS OTHERWISE NOTED
- 4) ALL DIMENSIONS ARE IN INCHES

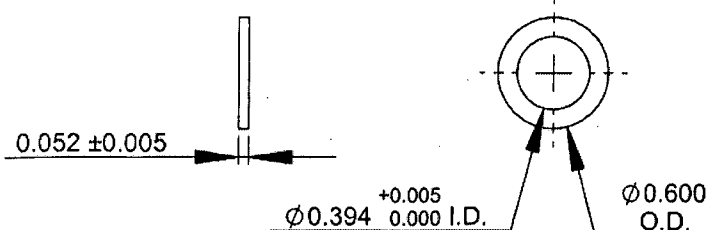





COPYRIGHT © 2003 BY DART AEROSPACE LTD.

THIS DOCUMENT IS PRIVATE AND CONFIDENTIAL AND IS SUPPLIED ON THE EXPRESS CONDITION THAT IT IS NOT TO BE USED FOR ANY PURPOSE OR COPIED OR COMMUNICATED TO ANY OTHER PERSON WITHOUT WRITTEN PERMISSION FROM DART AEROSPACE LTD.



DESIGN	DRAWN BY	<b>DART AEROSPACE LTD</b>
CHECKED	APPROVED	HAWKESBURY, ONTARIO, CANADA
DATE	DRAWING NO.	REV. C
04.02.17	D3183	SHEET 2 OF 4
TITLE	BRACKET ASSEMBLY	SCALE
		1:2

RELEASED  
04.03.01

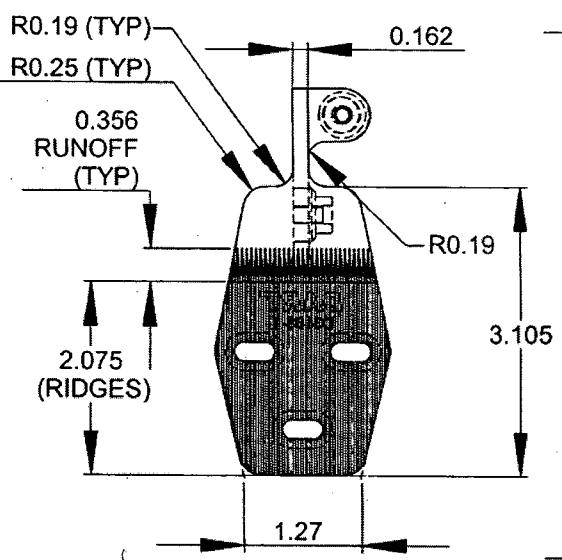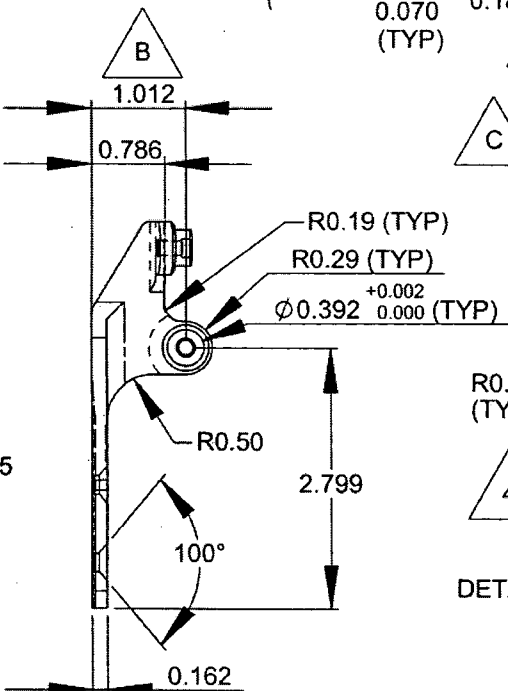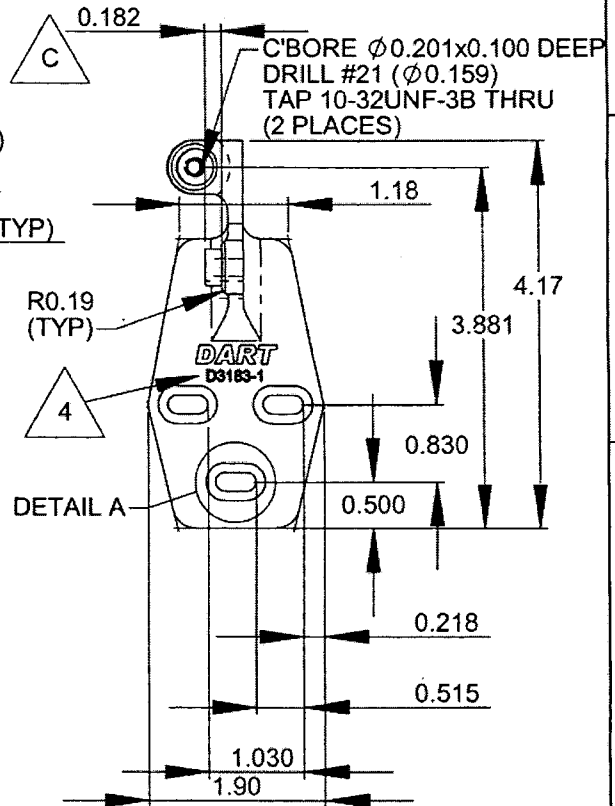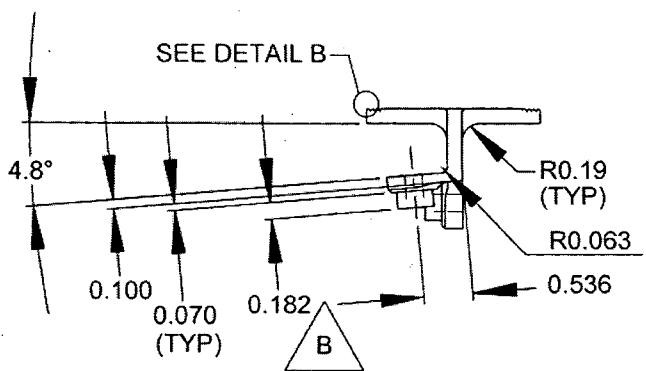

**D3183-1 BRACKET SHOWN  
D3183-2 BRACKET OPPOSITE**

- 1) D3183-1 CAN BE MADE FROM D3183-3  
D3183-2 CAN BE MADE FROM D3183-4
- 2) MATERIAL: 17-4 SS PER AMS 5604/5643  
(REF DART SPEC. M17-4-B)  
MIN ULTIMATE STRENGTH = 150 ksi  
MIN YIELD STRENGTH = 100 ksi
- 3) BREAK ALL SHARP EDGES 0.005 TO 0.015
- 4) ENGRAVE DART P/N & LOGO AS SHOWN
- 5) TOLERANCES ARE PER DART QSI 018 UNLESS OTHERWISE NOTED
- 6) ALL DIMENSIONS ARE IN INCHES

SHOP COPY  
RETURN TO  
ENGINEERING  
UNCONTROLLED COPY  
SUBJECT TO AMENDMENT  
WITHOUT NOTICE  
WORK ORDER  
NO. 345214



COPYRIGHT © 2003 BY DART AEROSPACE LTD.

THIS DOCUMENT IS PRIVATE AND CONFIDENTIAL AND IS SUPPLIED ON THE EXPRESS CONDITION THAT IT IS NOT TO BE USED FOR ANY PURPOSE OR COPIED OR COMMUNICATED TO ANY OTHER PERSON WITHOUT WRITTEN PERMISSION FROM DART AEROSPACE LTD.

**DART**



DESIGN	DRAWN BY	<b>DART AEROSPACE LTD</b>
CHECKED	APPROVED	HAWKESBURY, ONTARIO, CANADA
DATE	DRAWING NO.	REV. C
04.02.17	D3183	SHEET 3 OF 4
TITLE	BRACKET ASSEMBLY	SCALE
		1:2

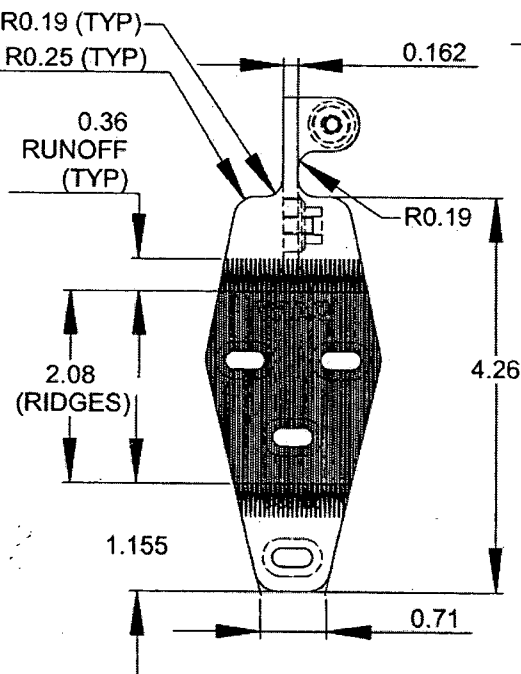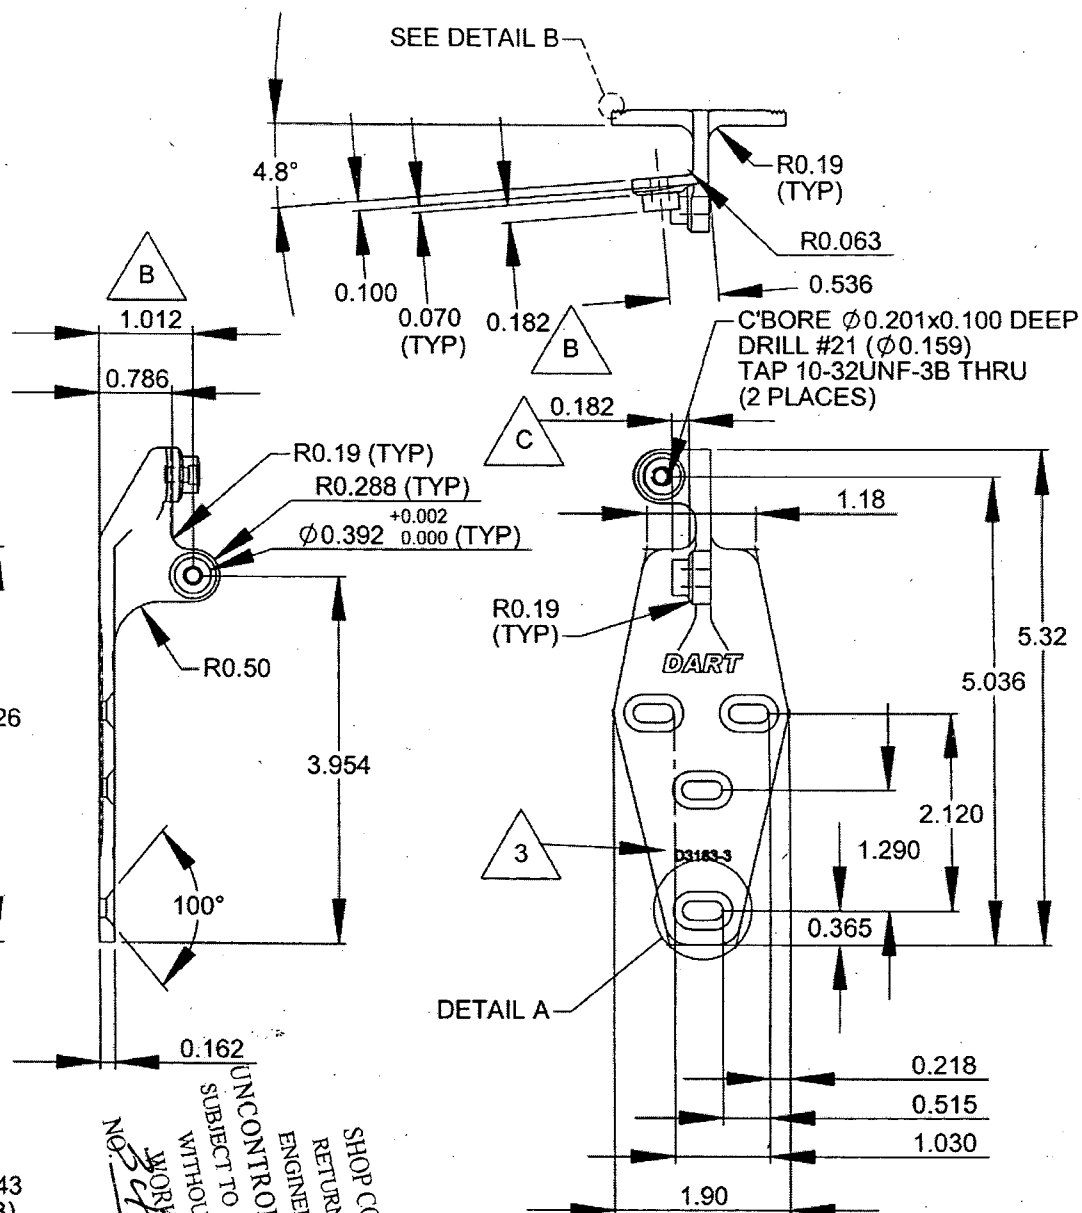

**D3183-3 BRACKET SHOWN**  
(REPLACES BELL P/N 412-030-304-105)  
**D3183-4 BRACKET OPPOSITE**  
(REPLACES BELL P/N 412-030-304-106)

- 1) MATERIAL: 17-4 SS PER AMS 5604/5643  
(REF DART SPEC. M17-4-B)  
MIN ULTIMATE STRENGTH = 150 ksi  
MIN YIELD STRENGTH = 100 ksi
- 2) BREAK ALL SHARP EDGES 0.005 TO 0.015
- 3) ENGRAVE DART P/N & LOGO AS SHOWN
- 4) TOLERANCES ARE PER DART QSI 018 UNLESS OTHERWISE NOTED
- 5) ALL DIMENSIONS ARE IN INCHES

SHOP COPY  
RETURN TO  
ENGINEERING  
UNCONTROLLED COPY  
SUBJECT TO AMENDMENT  
WITHOUT NOTICE  
WORK ORDER  
No. 34514

**RELEASED**  
04.03.01


COPYRIGHT © 2003 BY DART AEROSPACE LTD.

THIS DOCUMENT IS PRIVATE AND CONFIDENTIAL AND IS SUPPLIED ON THE EXPRESS CONDITION THAT IT IS NOT TO BE USED FOR ANY PURPOSE OR COPIED OR COMMUNICATED TO ANY OTHER PERSON WITHOUT WRITTEN PERMISSION FROM DART AEROSPACE LTD.






DESIGN <i>[Signature]</i>	DRAWN BY <i>[Signature]</i>	<b>DART AEROSPACE LTD</b> HAWKESBURY, ONTARIO, CANADA	
CHECKED <i>[Signature]</i>	APPROVED <i>[Signature]</i>	DRAWING NO. <b>D3183</b>	REV. C SHEET 4 OF 4
DATE <b>04.02.17</b>		TITLE <b>BRACKET ASSEMBLY</b>	SCALE 1:1

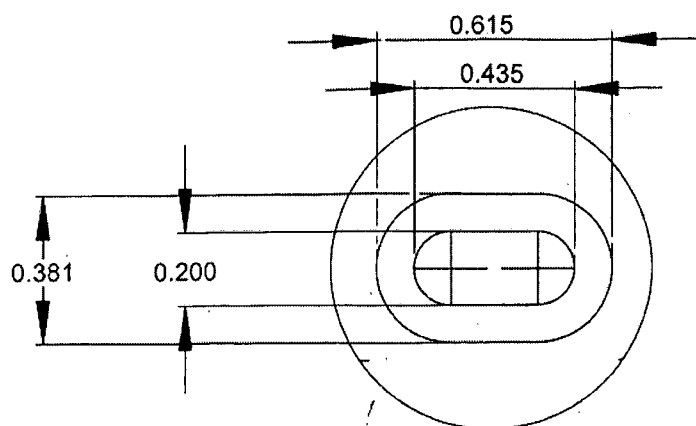


DETAIL A (2 : 1)

**RELEASED**  
04.03.01

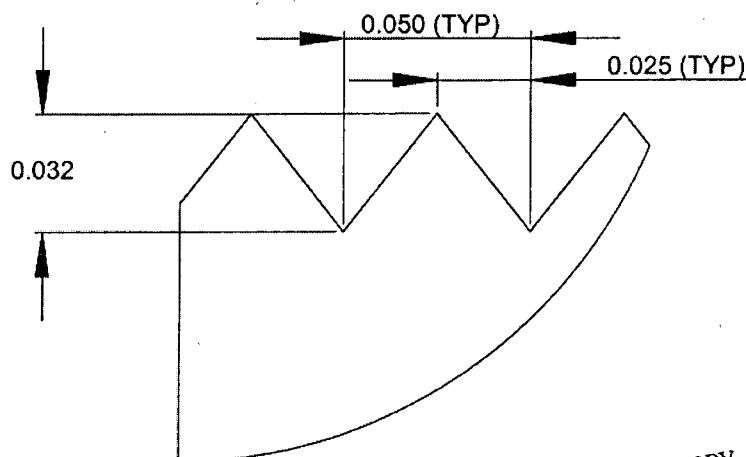

DETAIL B (20 : 1)

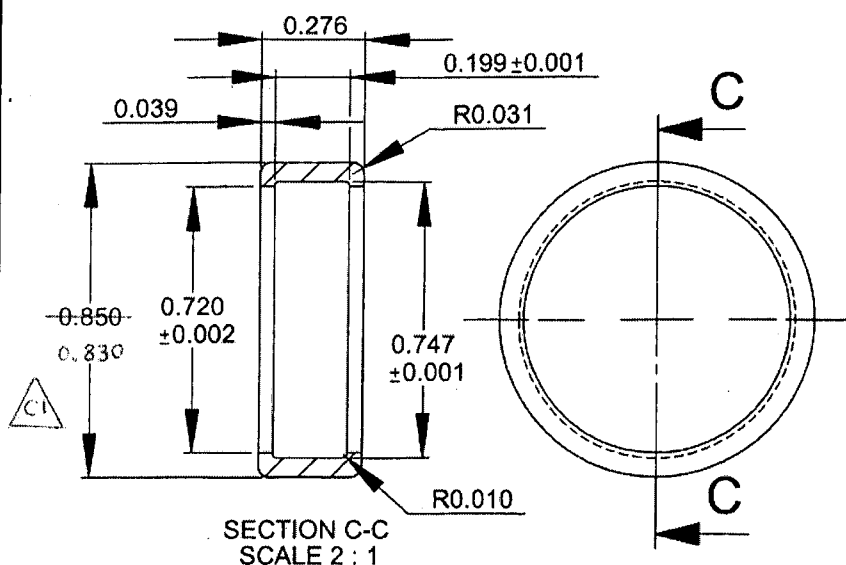

SHOP COPY  
RETURN TO  
ENGINEERING  
UNCONTROLLED COPY  
SUBJECT TO AMENDMENT  
WITHOUT NOTICE  
WORK ORDER  
NO. **34514**

**D3183-9 CAP**

- 1) MATERIAL: DELRIN ROD, Ø1.00  
(REF DART SPEC. M-DELRIN-R1.00)
- 2) TOLERANCES ARE PER DART QSI 018  
UNLESS OTHERWISE NOTED
- 3) ALL DIMENSIONS ARE IN INCHES

**D3183-045 BEARING ASSEMBLY**

- 1) ASSEMBLE D3183-5 BEARING AND  
D3183-9 CAP

**COPYRIGHT © 2003 BY DART AEROSPACE LTD.**

THIS DOCUMENT IS PRIVATE AND CONFIDENTIAL AND IS SUPPLIED ON THE EXPRESS CONDITION THAT IT IS NOT TO BE USED FOR ANY PURPOSE OR COPIED OR COMMUNICATED TO ANY OTHER PERSON WITHOUT WRITTEN PERMISSION FROM DART AEROSPACE LTD.